
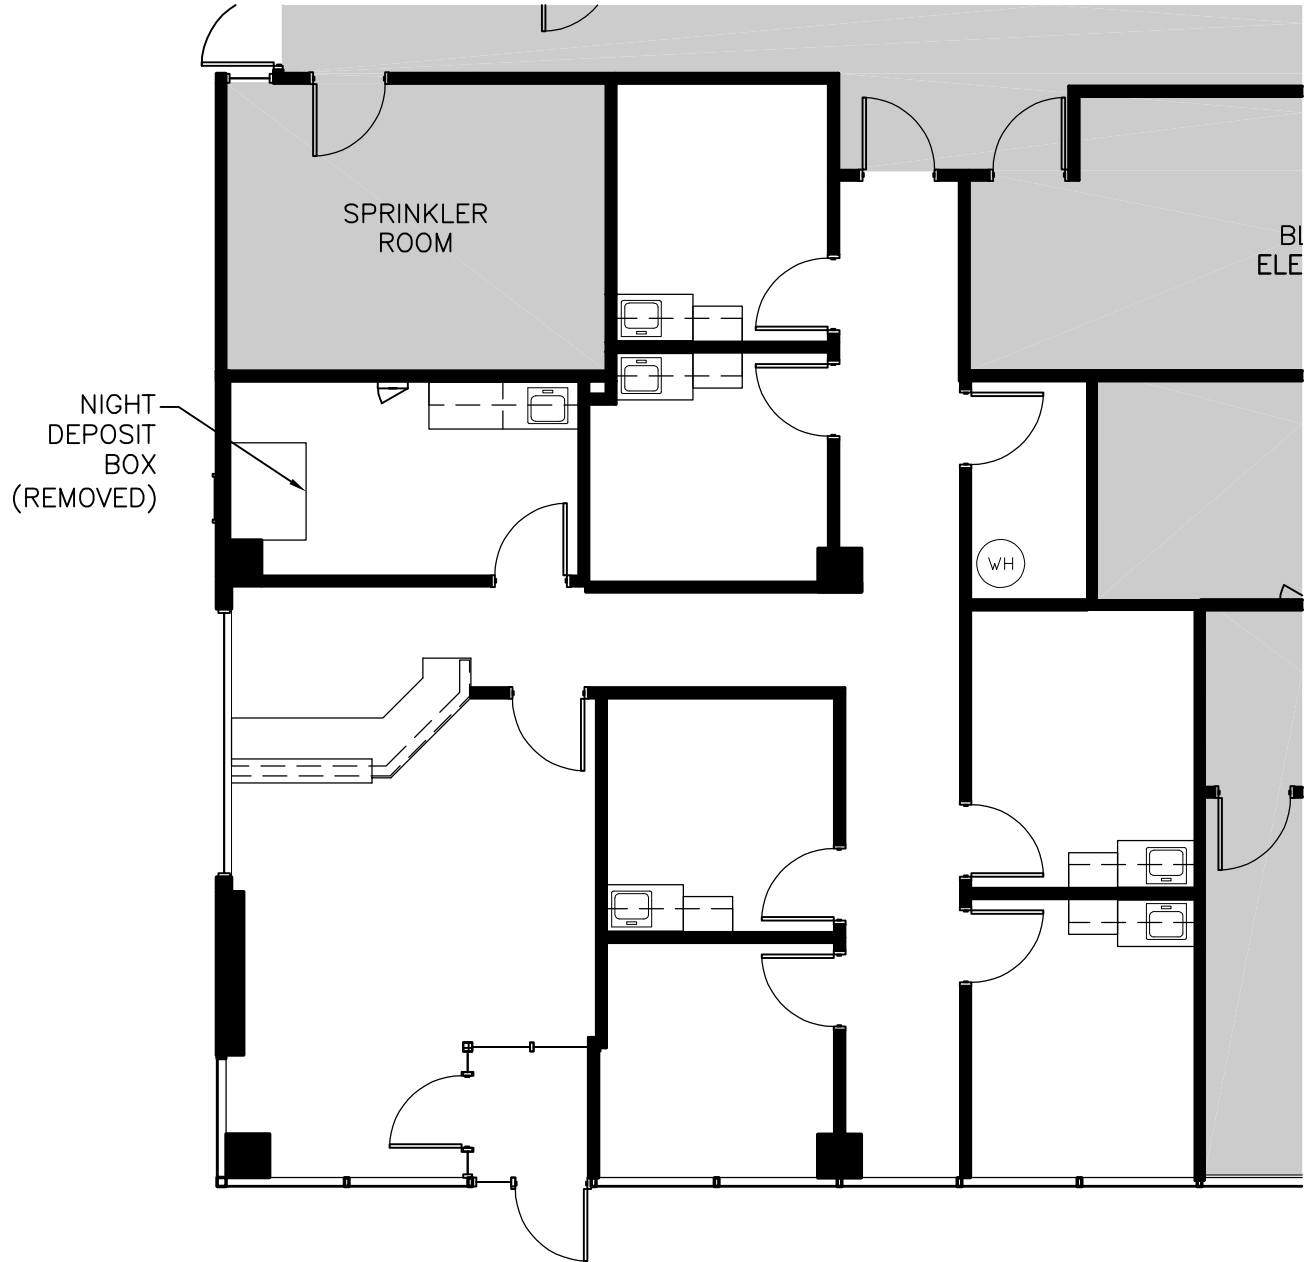


# ORLAND EXECUTIVE POINTE

15255 S. 94TH AVENUE  
ORLAND PARK, IL 60462

Key Plan:

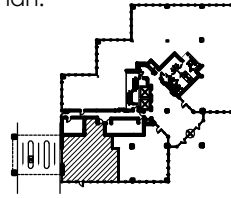

## Suite #111 - As-Built Conditions

1,716 Rentable Square Feet

Scale:

N.T.S.



North